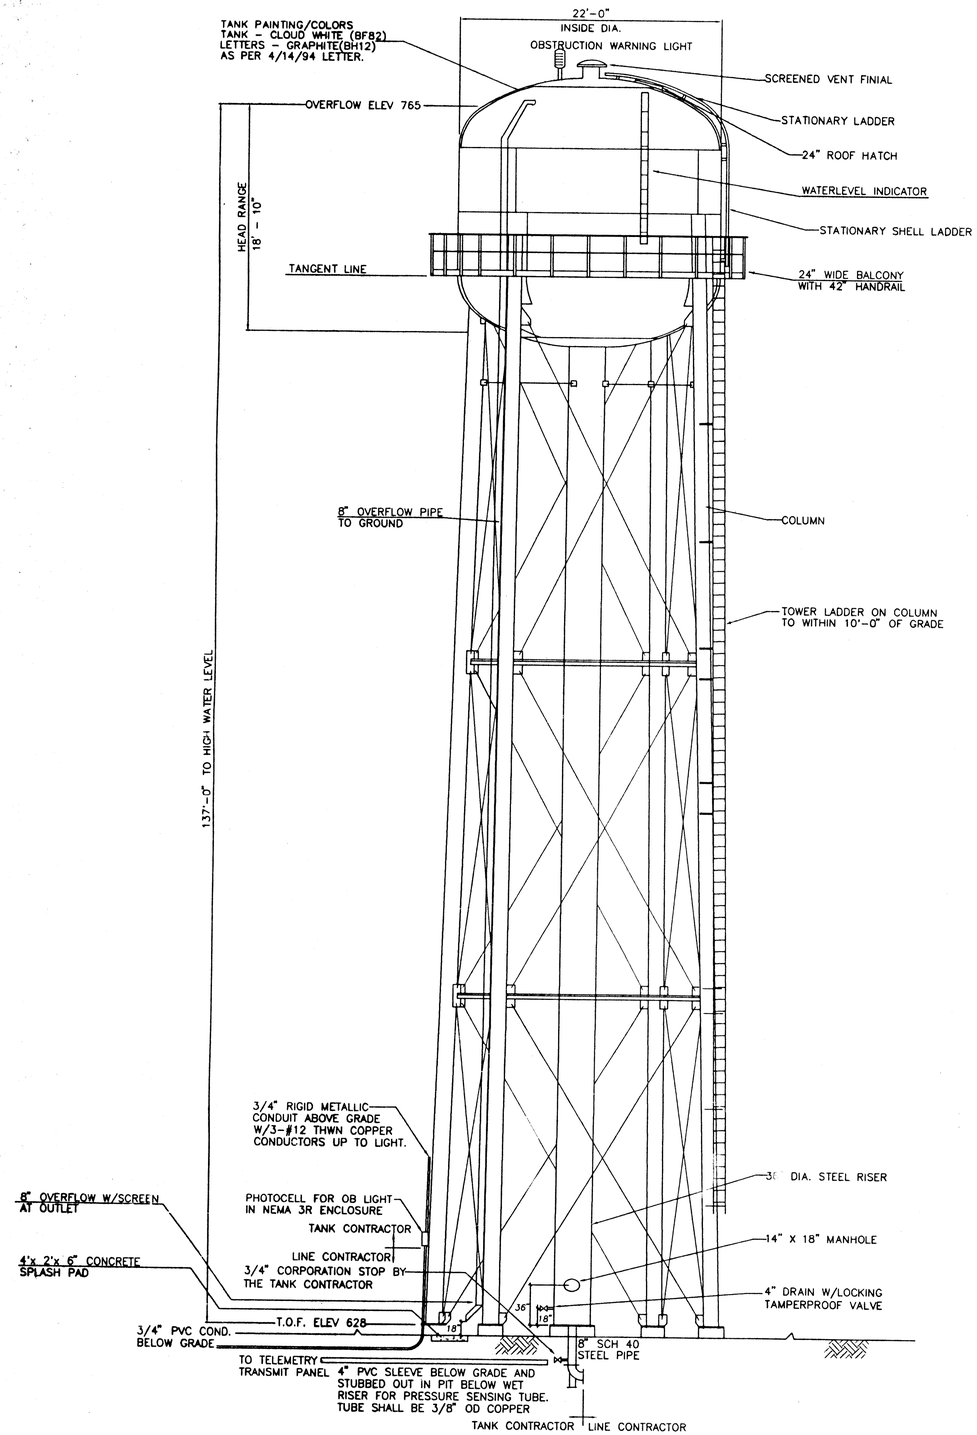

WATER STORAGE TANK SECTION

NO SCALE

TANK ORIENTATION

NO SCALE

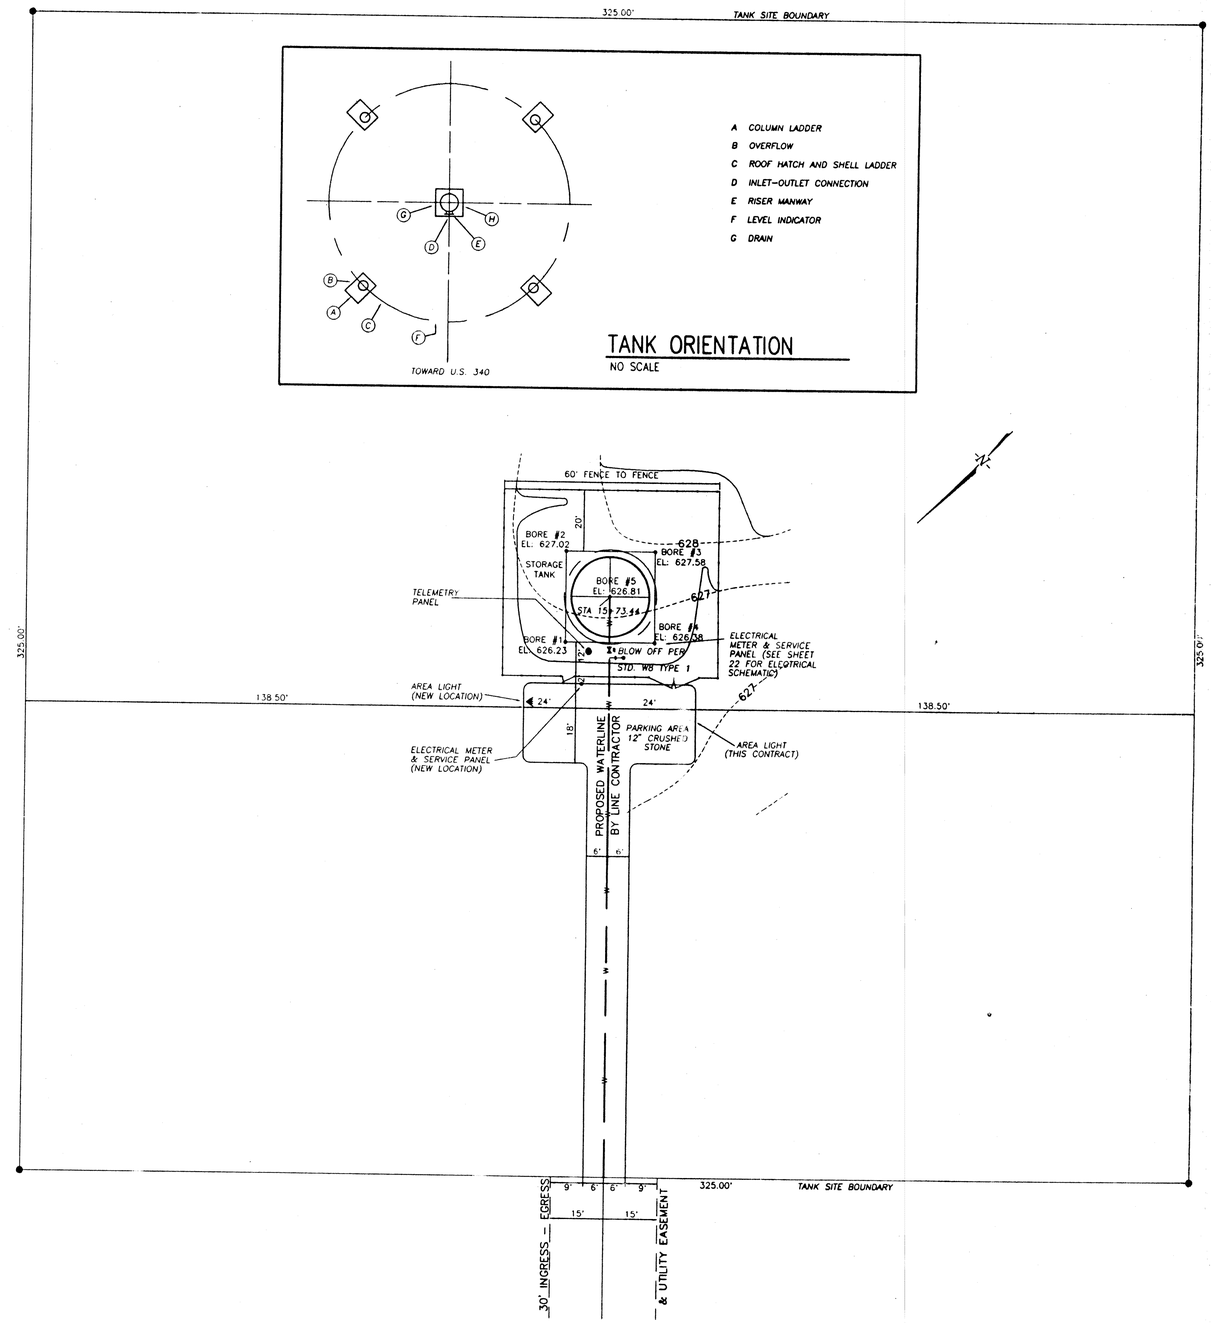

WATER STORAGE TANK PLAN

SCALE: 1" = 20'

WITHERS & RAVENEL
Engineering & Surveying, Inc.

Revisions			
No.	Description	Date	By

WHITE POST WATER SYSTEM

WATER STORAGE TANK DETAILS AS-BUILT

Designer SFR	Scale
Drawn By ATB	Date 1/02/95
Checked By SFR	Job No 92040

CAD File

Sheet No. 20 of 25